


Exhibit 50(a) OZAH Case No: CBA-1174-E

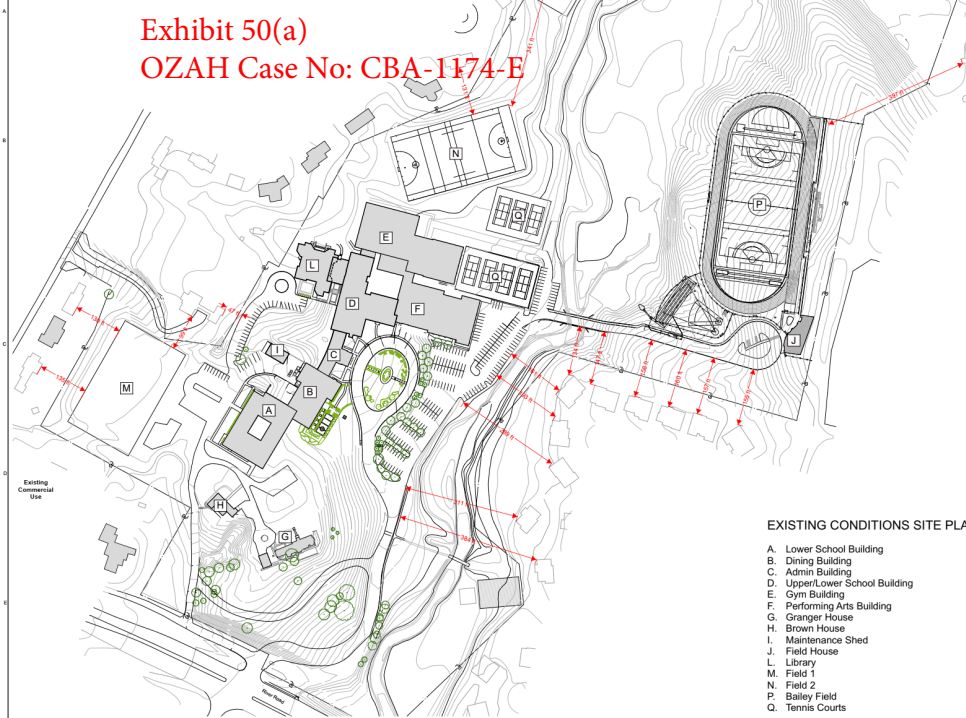

EXISTING CONDITIONS SITE PLAN KEY

- A. Lower School Building
- B. Dining Building
- C. Admin Building
- D. Upper/Lower School Building
- E. Gym Building
- F. Performing Arts Building
- G. Granger House
- H. Brown House
- I. Maintenance Shed
- J. Field House
- L. Library
- M. Field 1
- N. Field 2
- P. Bailey Field
- Q. Tennis Courts

1 Site Plan
SCALE: 1" = 40'

PROJECT



CLIENT

Holliston Arms School
7200 River Road
Bethesda, MD 20817
P: 301.352.1300

ARCHITECT

COGA Architects
2004 N Street NW
Washington, DC 20007
P: 202.385.7070
F: 202.385.7140



Professional Certification:
I hereby certify that these documents were
prepared and approved by me, and that I
am duly licensed professional architect
under the laws of the state of Maryland.
License No. 16613
Expiration Date: 07/12/2026

Mark	Date	Description
	09.12.25	Site Plan Modification

Drawing Title:

Existing Conditions Site Plan

Graphic Scale:



Project No:

2304

Date:

04.20.2023

Drawing No:

AS101



AS101